

**RESOLUTION NO. 2019-05**

**A RESOLUTION OF THE CITY OF BENTON CITY,  
WASHINGTON, APPROVING AN ALTERATION TO THE  
SUBDIVISION ENTITLED "SUNSET TERRACE"**

**WHEREAS**, an application was made to the City of Benton City requesting an alteration to the subdivision Sunset Terrace to amend the location of a cul-de-sac and lot lines, which had a final plat recorded with the Benton County Auditor on March 14, 1979, at Volume 13, page 21 by Ben Matson on behalf of Ben Matson and Scott Wingert; and

**WHEREAS**, RCW 58.17.215 authorizes a legislative body to approve an application for the alteration of a subdivision when all requirements have been satisfied; and

**WHEREAS**, the Planning Commission having held a public hearing on February 27, 2019; and at said meeting the Planning Commission voted to recommend approval of the final plat amendment for Sunset Terrace; and

**WHEREAS**, all requirements of RCW 58.17.215 have been properly met; and

**WHEREAS**, the Benton City Council having deliberated on this matter, and having determined that the public use and interest will be served by the alterations as applied for; NOW, THEREFORE,

**THE CITY COUNCIL OF THE CITY OF BENTON CITY, WASHINGTON**, hereby resolves as follows:


The subdivision entitled "Sunset Terrace" is hereby altered to relocate the cul-de-sac and revise the lot lines for lots 8, 9, 10, 11, 18 and 19 to match the as-built location, as shown on the Plat Amendment, a copy of which is attached hereto as Exhibit A, and the Mayor is hereby authorized and directed to sign the Plat Amendment reflecting the approved alterations, which shall be thereafter recorded with the Benton County Auditor.

**ADOPTED** this 5<sup>th</sup> day of March 2019, by the City Council of the City of Benton City, Washington, and signed in authentication of its passage this 5<sup>th</sup> day of March 2019.

Resolution 2019-05 filed and recorded in the office of the City Clerk of the City of Benton City, Washington, this 5<sup>th</sup> day of March 2019.

  
\_\_\_\_\_  
Linda Lehman  
Mayor

Attest:

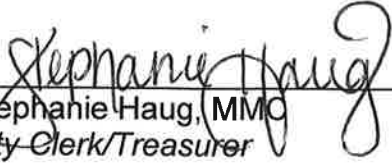
  
\_\_\_\_\_  
Stephanie Haug, MMC  
City Clerk/Treasurer

Approved as to Form:

  
\_\_\_\_\_  
Kerr Ferguson Law, PLLC  
City Attorney

EXHIBIT A:

PLAT AMENDMENT  
SUNSET TERRACE  
BENTON CITY, WA  
SEC 10, T9N, R27E

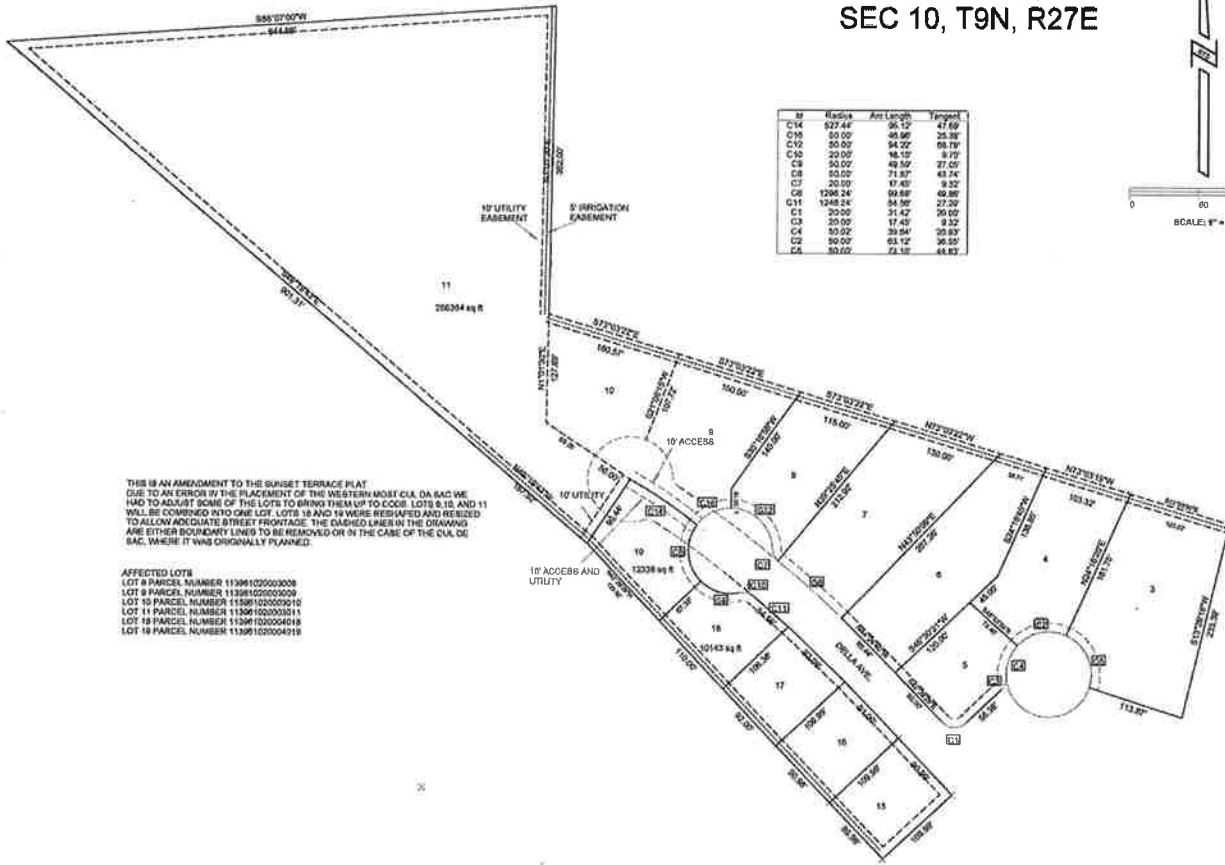

ID	Radius	Arc Length	Tangent
C14	929.44'	95.12'	47.59'
C15	50.00'	48.56'	25.38'
C12	50.00'	94.22'	58.78'
C13	20.00'	18.10'	9.77'
C8	50.00'	49.50'	27.00'
C8	50.00'	71.87'	43.74'
C7	20.00'	17.40'	9.32'
C6	1290.24'	99.88'	49.88'
C11	1248.24'	98.98'	27.00'
C1	20.00'	31.42'	15.71'
C3	20.00'	17.43'	9.32'
C4	50.00'	39.64'	20.33'
C2	50.00'	63.12'	36.55'
C5	50.00'	72.10'	44.83'

SCALE: 1" = 80'

THIS IS AN AMENDMENT TO THE SUNSET TERRACE PLAT DUE TO AN ERROR IN THE PLACEMENT OF THE WESTERN MOST CUL-DE-SAC WE HAD TO ADJUST SOME OF THE LOTS TO BRING THEM UP TO CODE. LOTS 9, 10 AND 11 WILL BE COMBINED INTO ONE LOT. LOTS 18 AND 19 WERE RE-SHAPED AND REDIVIDED TO ALLOW ADEQUATE STREET FRONTAGE. THE DASHED LINES IN THE DRAWING ARE EITHER BOUNDARY LINES TO BE REMOVED OR IN THE CASE OF THE CUL-DE-SAC, WHERE IT WAS ORIGINALLY PLANNED.

AFFECTED LOTS  
LOT 9 PARCEL NUMBER 113961020003008  
LOT 9 PARCEL NUMBER 113961020003009  
LOT 10 PARCEL NUMBER 113961020003010  
LOT 11 PARCEL NUMBER 113961020003011  
LOT 18 PARCEL NUMBER 113961020004018  
LOT 19 PARCEL NUMBER 113961020004019

AMTOR'S CERTIFICATE  
FILED FOR RECORD THIS \_\_\_ DAY OF \_\_\_ AT \_\_\_  
IN BOOK \_\_\_ OF PLATS AT PLACE \_\_\_  
AT THE REQUEST OF LAWRENCE W. SARGENT  
BENTON COUNTY AUDITOR  
FEE NO. \_\_\_\_\_ SURVEY NO. \_\_\_\_\_

WILLIAM HARRIS BENTON COUNTY AUDITOR

THIS MAP CORRECTLY REPRESENTS A SURVEY MADE BY ME OR UNDER MY SUPERVISION AND IN ACCORDANCE WITH THE REQUIREMENTS OF THE SURVEY RECORDING ACT AT THE REQUEST OF \_\_\_\_\_

LAND SURVEYING TECHNICIAN, LICENSE NO. \_\_\_\_\_  
LCT (Not a State Job)  
PROFESSIONAL ASSOCIATION  
PLATS AND PLATS

BENTON COUNTY RECORD OF SURVEY FOR  
BEN MATSON  
PASCO, WA 99632  
PPLS 10-16 SEC. 10, T9N, R27E

JOB # 4112

1 of 1